FC 4074
RICHARDS LOT 30A
2-4-1761
2-4-1762
JOHN A WALLINBOUGH
BC&S 30-221

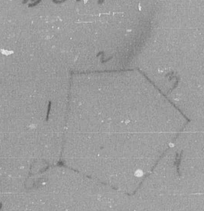

NEAR CAVE BRANCH
Between the branch & the South Mountain

FC 4251
3 COTTS & BRIEF 100A
2-12-1752
5-4-1752
WM DOUGLAS
Y&S #7-502

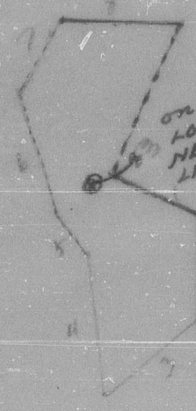

on W.S LONG MEADOW NEAR END 1ST LINE OF CHARLTONS VICTORY

WAS # 859
3 HNABLEYS NEGLECT
1H 3/4A
4-23-1788
5-14-1789
DB HENRY SCHNEDLEY
1CHD-484

END 9TH LINE SCHNEDLEYS PART RES ON PELICAN COVE SCHUT TIMBER
FOUND IGP on 1st line SINKHOLE

FC 4435
SMALL TIMBER 293A
2-17-1765
2-17-1765
JOHN HENCH
BC&S 30-193
Bay at Bay & LOMBARTS 9 TRIP

FC ENY 4165
ROSS GOOD LUCK 10A
5-21-1760
5-21-1761
ROSS MELLIN
BC&S 12-513

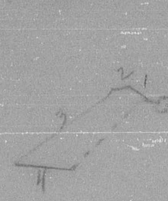

M.S draft & Antietam ck

FC 4544
STONE + TIMBER 36A
2-19-1771
4-20-1774
JACOB MILLER
BC&S 47-497

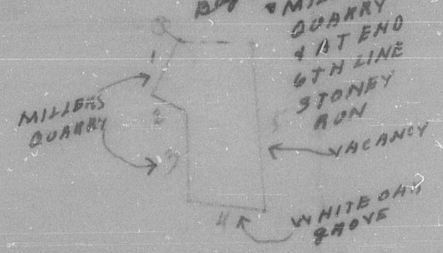

Bay at Bay & "MILLERS QUARRY" 4 BT END 6TH LINE STONEY RUN
MILLERS QUARRY
VACANCY
WHITE OAK GROVE

FC ENY 4126
ROCKEY LAND 40A
GEORGE MAY 9/30/1776
JOHN HIETENOMON
1CH1-71

FC 3662 & 3662A
RES ON MT OLIVET - SWEEDLAND
+
TIED DOG
117 1/4A
9-4-1765 10-28-1765
CASPER SMITH - 752A
BC&S 27-152

A RES ON MT OLIVET 8/19/1703 487A
CASPER SMITH
SWEEDLAND 12/17-1741
JOHN FRIEND 50A
TIED DOG 8/30-1752
JOHN YOHOW 27A
THE 117 1/4A TRACT IS A RES ON THE 752A TRACT
RED LINES
GREEN LINES

JUST BY CHANCE 316A
SWEEDLAND
MT OLIVET
TIED DOG 27A
VAC

on the South Mtn about 5P from TICTOM RUN

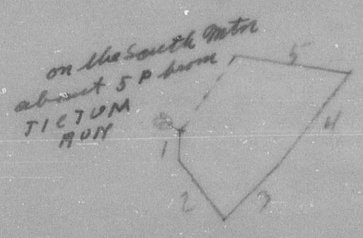

ENY 3661
RES ON MT OLIVET
487A
10-8-1703
8-10-1703
CASPER SMITH
Y&S #1-94
BLUE LINES
A RES ON MT OLIVET 364A
6-4-1731
THOS CRESAP
SORV 11-6-1750
PAT 11-6-1750
BY Y&S #8-621

MT OLIVET 364A

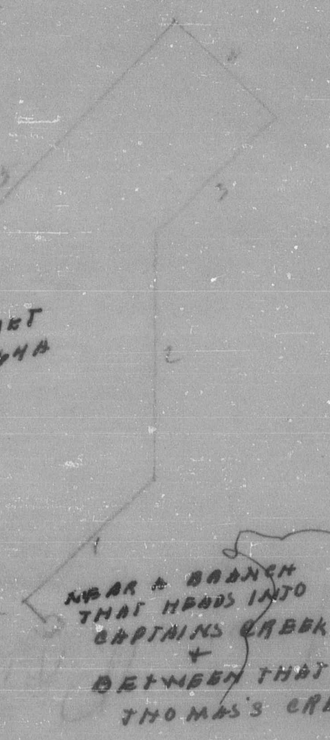

NEAR A BRANCH THAT HEADS INTO CAPTAINS CREEK + BETWEEN THAT + THOMAS'S CREEK